

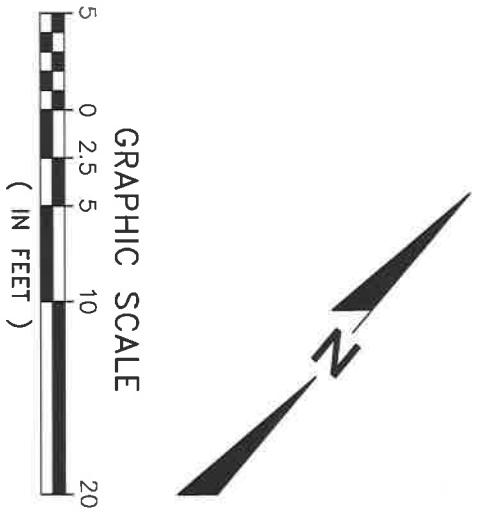


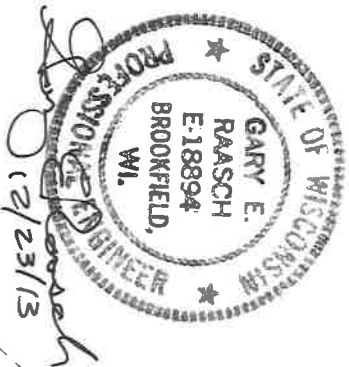

P.P.#71-10423
BM, NAIL IN PP EL=744.32 (RASN BM JUNE 2010),
MAG NAIL IN PP EL= 745.56 (WDNR BM 745.43 REC. 1991),
MAG NAIL IN PP EL=744.77 (FOUND NAIL IN POLE)

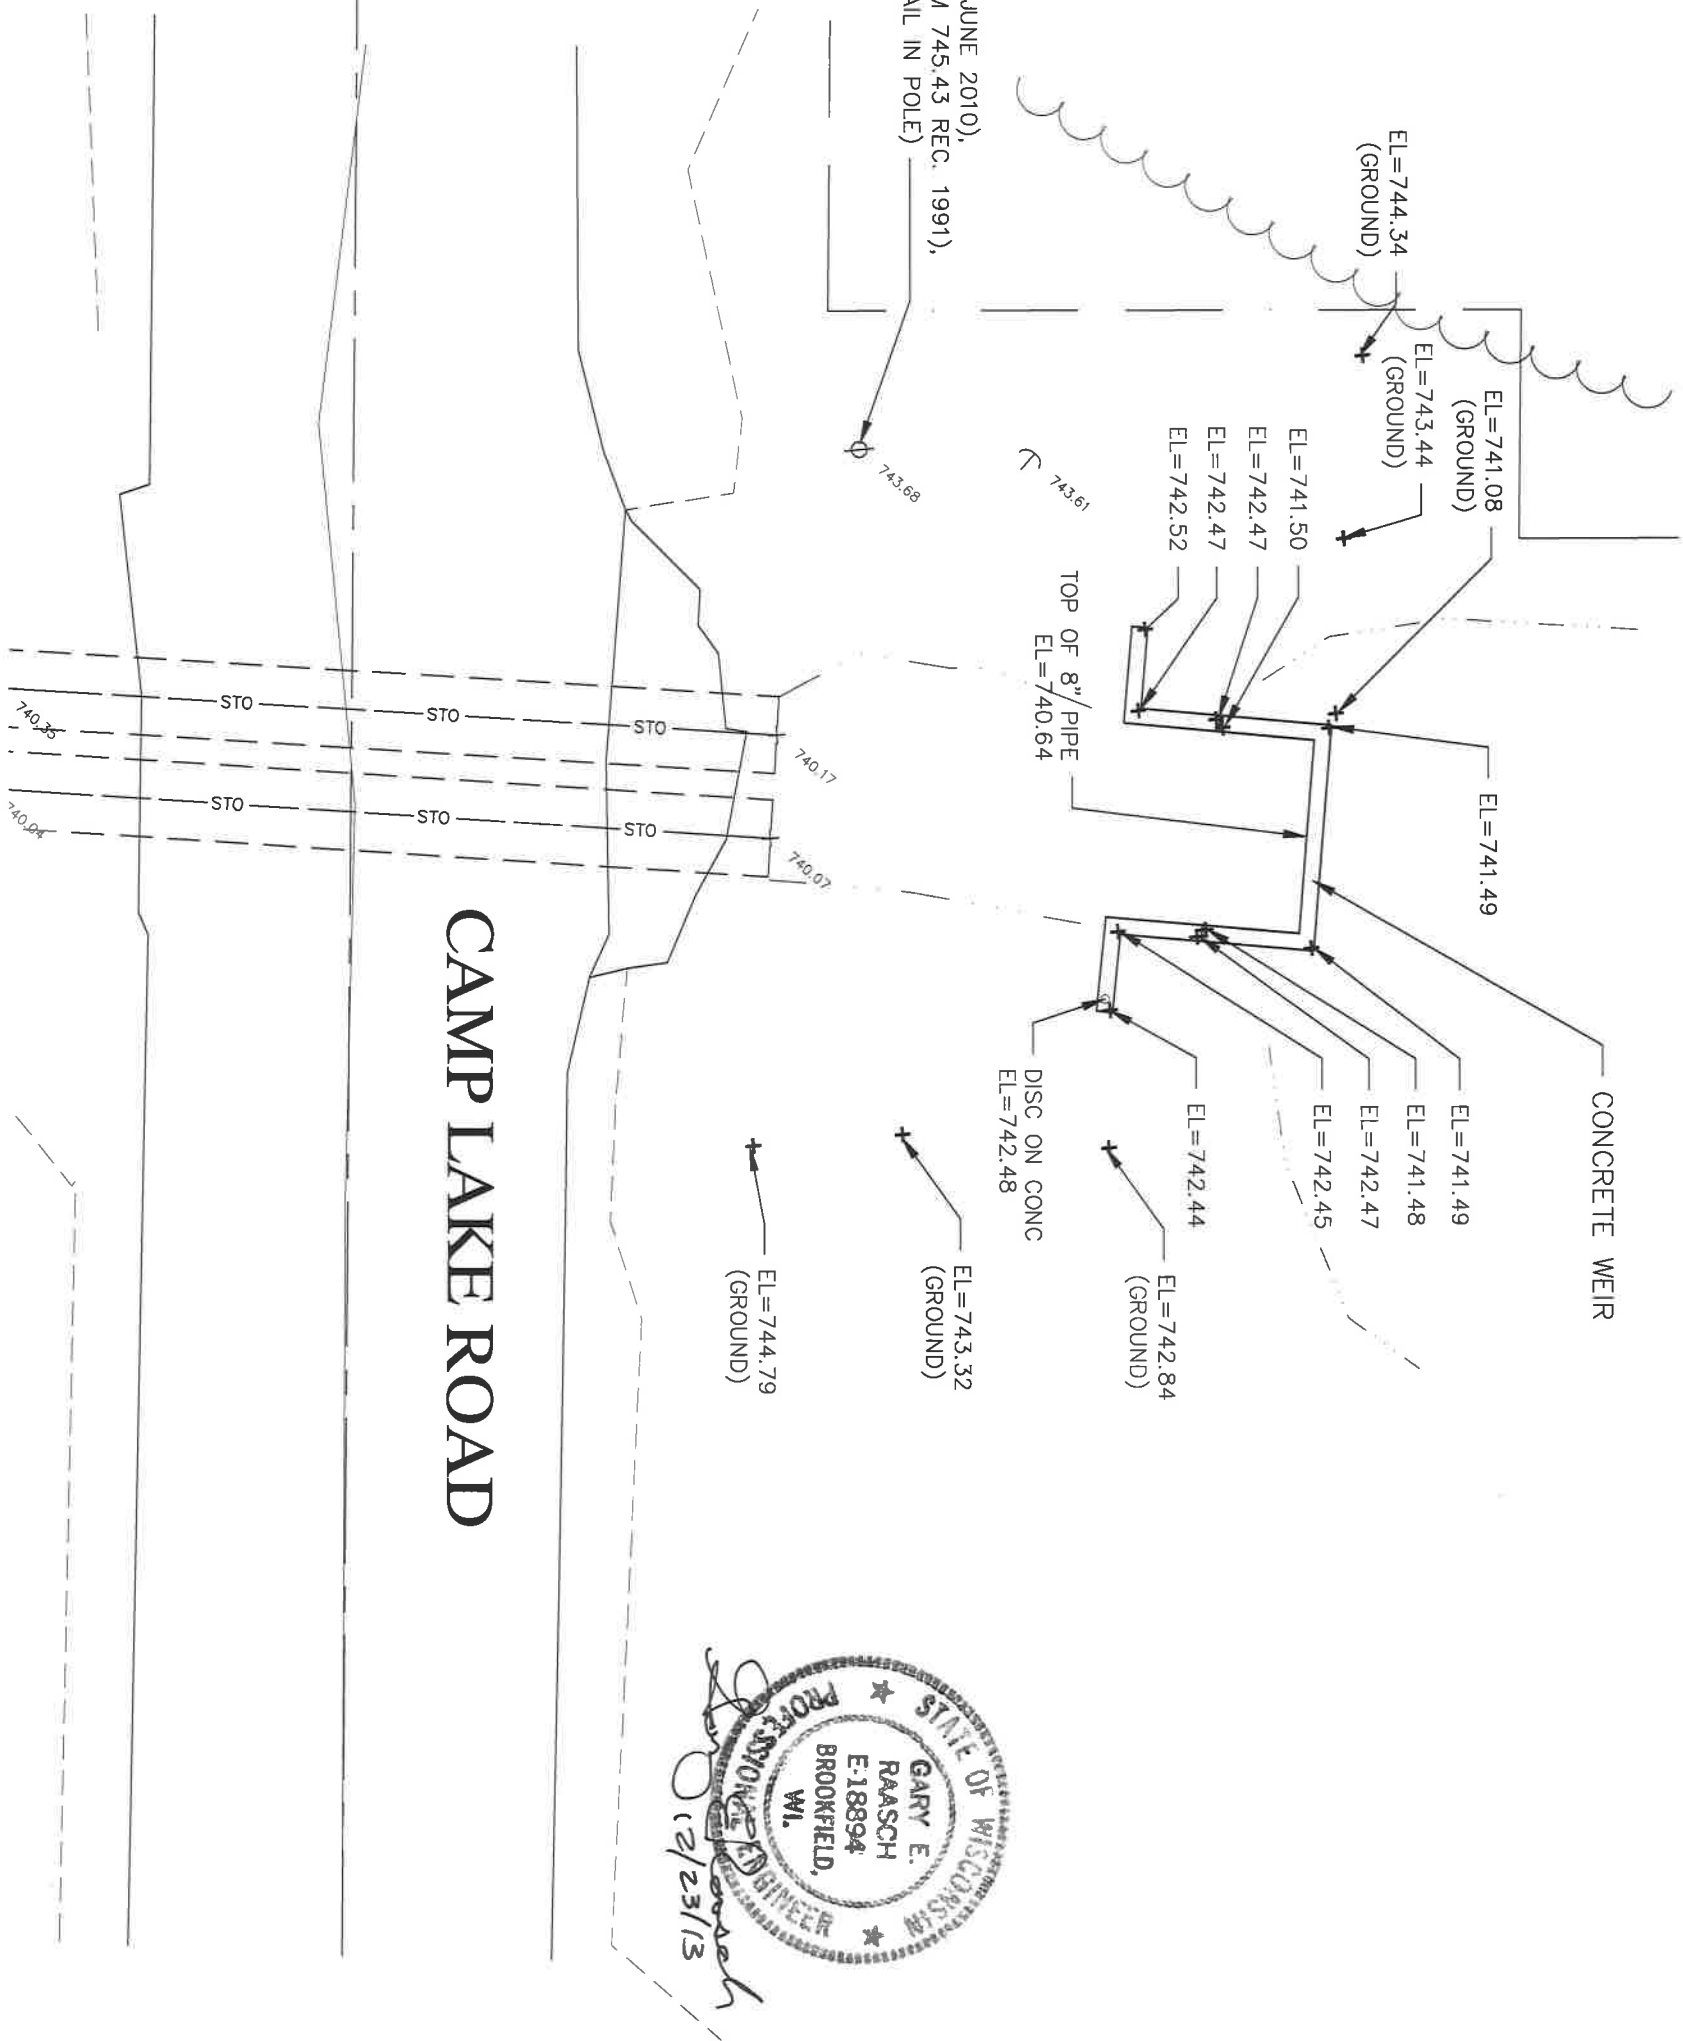

CENTER LAKE DAM RECONSTRUCTION
TOWN OF SALEM, KENOSHA COUNTY, WI

RECORD DRAWING

R.A. Smith National
*Beyond Surveying
and Engineering*

16745 W. Bluemound Road, Brookfield, WI 53005-5938
262-781-1000 Fax 262-781-8486, www.raasmiternational.com
Appleton, WI Orange County, CA Pittsburgh, PA

DATE	DESCRIPTION

© COPYRIGHT 2013
R.A. Smith National, Inc.
DATE: 12/23/2013
SCALE: 1" = 10'
JOB NO. 1110136
PROJECT MANAGER:
G. E. RAASCH, P.E.
DESIGNED BY: GER
CHECKED BY: CVD

SHEET NUMBER